

STATE OF UTAH  
DEPARTMENT OF NATURAL RESOURCES  
DIVISION OF OIL, GAS AND MINING  
1594 West North Temple - Suite 1210  
Box 145801  
Salt Lake City, Utah 84114-5801  
Telephone: (801) 538-5291  
Fax: (801) 359-3940

RECEIVED E-Mail  
JAN 12 2010  
Div. of Oil, Gas & Mining

LARGE MINING OPERATIONS 2008 PROGRESS REPORT  
January 1, 2009 to December 31, 2009

The information required in this form are based on provisions of the Mined Land Reclamation Act, Title 40-8, and the rules as under the Utah Minerals Regulatory Program.

1. Mine Permit Number: M/037/001
2. Mine Name: Lisbon Mine
3. Name of Operator/Permittee: Rio Algom Mining LLC  
Note: If Operator's address, company representative or phone number have changed, please provide a replacement page for the Notice of Intention.
4. Mine Location: 355 South Lisbon Road, Sec. 21 T295R24E
5. Report the gross amount of ore mined and waste moved, and the disposition of the materials (onsite stockpiles, sold, waste pile, regraded, etc.):  

Gross Ore Mined	<u>0</u>	Tons, or	<u>0</u>	yd <sup>3</sup>
Waste Material Moved	<u>0</u>	Tons, or	<u>0</u>	yd <sup>3</sup>
New Disturbance	<u>0</u>	Acres during 2009		
Area Reclaimed	<u>0</u>	Acres during 2009		
Total Disturbed Area	<u>0</u>	Acres*		

\*Total mine disturbance from the beginning of mining operations through the end of 2009

Was the ore shipped off site? If not, where is the ore located? N/A

Where is the waste located? Reclaimed
6. Briefly describe the reclamation work performed during the past year. A map showing reclaimed areas and dates is suggested. (Submit form MR-SITE for an application for full or partial bond/site release).  
Disturbed areas re-seeded  
MR - site filed 10-1-2005.
7. Include an updated map depicting surface disturbance and reclamation performed during the year, prepared in accordance with Rule R647-4-105.

I hereby certify, under penalties of law, the information provided in this report is true and correct to the best of my knowledge and belief.


Name (Typed or Print): Terry L. Fletcher  
Title of Operator: Rio Algom Mining LLC  
Signature of Operator: Terry L Fletcher  
Date: 1-11-10



RECEIVED E-Mail

JAN 12 2010

Div. of Oil, Gas & Mining

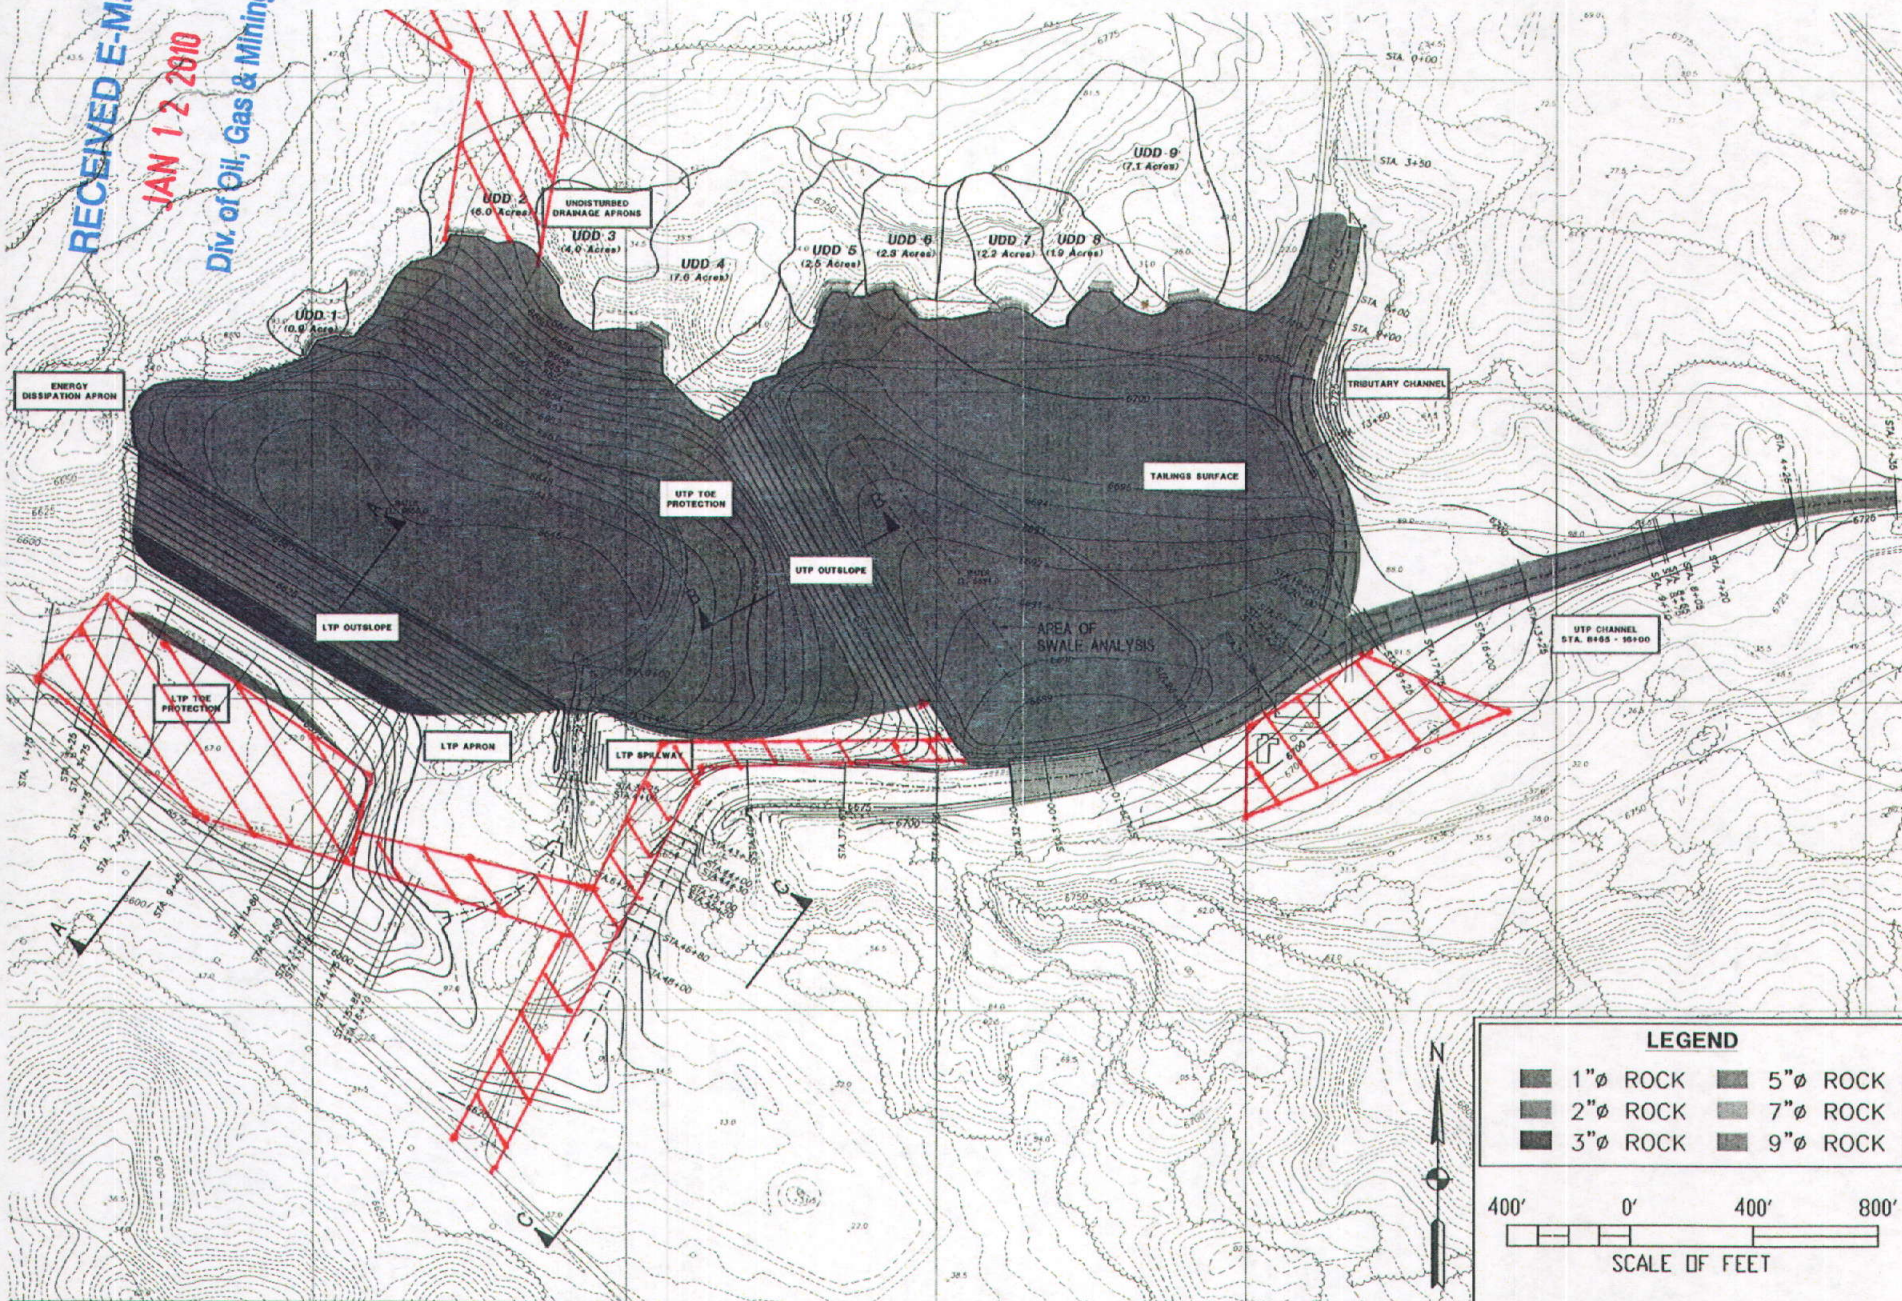

Areas Re-Seeded in 2009

C.H. GUERNSEY & COMPANY  
Engineers • Architects • Consultants  
5555 North Grand Blvd.  
Oklahoma City, OK  
405-416-8100



**GENERAL SITE LAYOUT**  
RIO ALGOM MINING CORP., LISBON MILL SITE  
SAN JUAN COUNTY, UTAH

DRAWN BY: SWT/TMC  
APPROVED BY: GEH  
DATE: AUGUST 30, 2002  
JOB NO: OK075589003

**FIGURE II**



# Rio Algom Mining LLC

RECEIVED E-Mail

JAN 12 2010

Div. of Oil, Gas & Mining

January 11, 2010

Ms. Susan White  
Department of Natural Resources  
Division of Oil, Gas and Mining  
1594 West North Temple - Suite 210  
Salt Lake City, Utah 84114-5801

Re: Mine Permit M/037/001  
Annual Report (form MR-AR) for 2009

Dear Ms. White:

Please find the attached 2009 Annual Report for Rio Algom Mining LLC's Lisbon Mine. This report is required by Rules R647-003-116 and R647-004-121 of the Division's Amended and New Rules - Mineral Reclamation Program.

Rio Algom Mining LLC has completed all major reclamation activities at the site. In 2009 three previously disturbed areas were re-seeded. Please refer to the attached general site layout depicting the 2009 re-seeding red.

Rio Algom Mining LLC submitted a request for bond release in 2006. Our legal department is currently in contact with the Board to terminate or reduce the bond to an appropriate level to cover costs associated with revegetation monitoring.

If you have any questions on this submittal or if you need additional information, please contact me at (505) 287-8851 - Ext. 11.

Respectfully submitted,



Billy Ray  
Project Engineer

Attachments: As Stated.